

MULTIPLE EXISTING PUBLIC AND PRIVATE UTILITY LINES EXIST ON THIS SITE. THE UTILITY LINES SHOWN ON THESE DRAWINGS REFLECT INFORMATION OBTAINED FROM RECORD DRAWINGS AND MAY NOT INCLUDE ALL EXISTING UTILITIES. CONTRACTOR IS TO USE EXTREME CAUTION DURING ALL CONSTRUCTION ACTIVITIES AND IS SOLELY RESPONSIBLE FOR DAMAGE TO EXISTING FACILITIES.

FLOODPLAIN NOTE:

BFE = 66.00' (100-YR) & 68.75' (500-YR)

ACCORDING TO THE MAP NO. 48201C0295M AND 48201C0315L OF THE FEDERAL EMERGENCY MANAGEMENT AGENCY'S FLOOD RATE MAPS, DATED JUNE 9, 2014 AND JUNE 18, 2007, THE SITE LIES IN UNSHADED ZONE "X", SHADED ZONE "X", ZONE "AE".

DETENTION FACILITY MAINTENANCE NOTE:

THE PROPOSED PRIVATE DETENTION FACILITY IS TO BE MAINTAINED BY THE PROPERTY OWNER.

MITIGATION CALCS:

TOTAL FLOODPLAIN FILL	10,619 CY
TOTAL FLOODPLAIN CUT	10,869 CY
NET CUT	250 CY CUT
*ALL NUMBERS HAVE BEEN CALCULATED THROUGH AUTOCAD 2020 CIVIL 3D MODELING.	

GENERAL NOTES

- CONTRACTOR TO ADJUST ALL EXISTING AND PROPOSED UTILITY APPURTENANCES TO FINISHED GRADE.
- ALL EXCAVATED MATERIAL TO BE HAULED OFFSITE.

FAA RESTRICTED NOTE:

PURSUANT TO FAA ADVISORY CIRCULAR 150/5200-33B 2-3 SUB-SECTION B: STORM WATER DETENTION PONDS SHOULD BE DESIGNED, ENGINEERED, CONSTRUCTED, AND MAINTAINED FOR A MAXIMUM 48-HOUR DETENTION PERIOD AFTER THE DESIGN STORM AND REMAINS COMPLETELY DRY BETWEEN STORMS.

DETENTION DRAINAGE NOTE:


ALL SUBSURFACE DRAINAGE SYSTEMS ARE REQUIRED TO BE DRAINED IN 48 HOURS.

TOTAL DETENTION/MITIGATION POND VOLUME SUMMARY

TOTAL DETENTION VOLUME PROVIDED	334,638 CU FT
TOTAL MITIGATION VOLUME PROVIDED	293,463 CU FT
TOTAL STORAGE VOLUME PROVIDED	628,101 CU FT


IMPERVIOUS COVER CALCS:

TOTAL SITE ACREAGE	20.032 ACRES
TOTAL IMPERVIOUS COVER	13.349 ACRES
PERCENTAGE OF TOTAL IMPERVIOUS COVER	66.64%

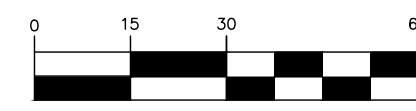

GRAPHIC SCALE

City of Houston Texas

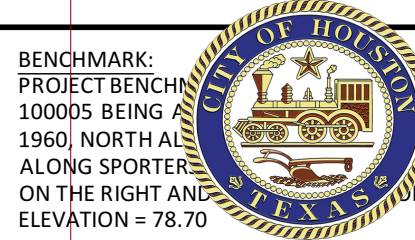

TEMPORARY BENCHMARK "A" IS A BOX CUT SET ON A STORM INLET FOUND ON WEST LAUREL SPRINGS LANE, BEING AT THE INTERSECTION OF THE SOUTHERLY MYSTIC GLEN LOOP AND LAUREL SPRINGS LANE. ELEVATION = 78.70

TEMPORARY BENCHMARK "B" IS A BOX CUT SET ON A STORM INLET FOUND ON THE WEST LAUREL SPRINGS LANE, BEING AT THE INTERSECTION OF THE NORTHERLY MYSTIC TRAIL LOOP AND LAUREL SPRINGS LANE. ELEVATION = 83.71

LEGEND

●	EX. MANHOLE
—	EX. STORM SEWER
—	EX. WATER LINE
—	EX. SANITARY SEWER LINE
—	EX. OVERHEAD POWER LINE
—	EX. UNDERGROUND GAS LINE
—	EX. CONTOUR
—	PROPOSED STORM SEWER
—	PROPOSED GRATE INLET

TOTAL DETENTION VOLUME REQUIRED

$$V_T = [43,560 \times (0.50 \times A_p)]$$
$$V_T = \text{TOTAL DETENTION VOLUME FOR THE PROPOSED PROJECT (CUBIC FEET)}$$

$$A_p = \text{AREA OF INCREASED IMPERVIOUS COVER (ACRES)}$$

$$V_T = [43,560 \times (0.50 \times 13.349)] = 290,763 \text{ CU FT}$$

TOTAL DETENTION VOLUME PROVIDED

TOTAL DETENTION PROVIDED	= 334,638 CU FT
DETENTION PROVIDED IN POND	= 334,638 CU FT

DETENTION CALCULATIONS

TOTAL SERVICE AREA=	20.032 AC
EXISTING IMPERVIOUS COVER=	0 AC
PROPOSED IMPERVIOUS COVER=	13.349 AC
INCREASED IMPERVIOUS COVER=	13.349 AC
REQUIRED DETENTION VOLUME=	6,675 AC-FT
PROVIDED DETENTION VOLUME=	7,882 AC-FT
OUTFLOW RATE ALLOWED FOR LOW FLOW=	10,016 CFS
OUTFLOW RATE ALLOWED FOR HIGH FLOW=	19,748 CFS
OUTFLOW RATE PROVIDED FOR LOW FLOW=	3.59 CFS
OUTFLOW RATE PROVIDED FOR HIGH FLOW=	7.18 CFS
PRIMARY RESTRICTOR SIZE=	1 PUMP RUNNING
SECONDARY RESTRICTOR SIZE=	2 PUMPS RUNNING

RESTRICTOR CALCULATIONS

MAX WSE = 67.35
75% WSE = 64.98
25% WSE = 60.23

LOW LEVEL RESTRICTOR (25% FLOW)

TOTAL DRAINAGE AREA= 20.032 ACRES
OUTFLOW RATE ALLOWED FOR LOW FLOW $Q^1 = 10,016 \text{ CFS}$
HEAD H^1 (WATER SURFACE DIFFERENTIAL FOR LOW FLOW= 2.05 FEET)
CALCULATED LOW LEVEL RESTRICTOR SIZE $D^1 = 1.18 \text{ FEET}$
PROVIDED/ DESIGNED LOW LEVEL RESTRICTOR SIZE $D^1 = 1.18 \text{ FEET}$

HIGH LEVEL RESTRICTOR (75% FLOW)

TOTAL DRAINAGE AREA= 20.032 ACRES
TOTAL OUTFLOW RATE ALLOWED (100%) $Q = 19,748 \text{ CFS}$

RE-CALCULATED HEAD H^2 (WATER SURFACE DIFFERENTIAL) FOR LOW LEVEL RESTRICTOR = 2.05 FEET
RE-CALCULATED LOW FLOW Q^2 FOR LOW FLOW LEVEL RESTRICTOR = 10,016 CFS

OUTFLOW RATE ALLOWED FOR HIGH FLOW Q^H (75%) = 14,811 CFS
HEAD H^H (WATER SURFACE DIFFERENTIAL FOR HIGH LEVEL RESTRICTOR= 7.18 FEET)
CALCULATED HIGH LEVEL RESTRICTOR SIZE $D^H = 1.62 \text{ FEET}$
OUTFLOW RATE PROVIDED FOR HIGH FLOW $Q^H = 14,811 \text{ CFS}$

CL OF PRIMARY RESTRICTOR - N/A
CL OF SECONDARY RESTRICTOR - N/A

$$0.50 \times \text{TOTAL DRAINAGE AREA} = 0.50 \times 20.032$$
$$25\% \text{ WSE} - \text{CL OF PRIMARY RESTRICTOR} = 60.23 - 58.18$$
$$Q^1 \text{ } 1/2 \text{ } (2.25H^1 \text{ } 1/4) = 10,016 \text{ } 1/2 \text{ } (2.25 \times 2.05 \text{ } 1/4)$$

20.032 ACRES
10,016 CFS (BASED ON 0.5 CFS/AC)
2.05 FEET
1.18 FEET
1 PUMP RUNNING @ 1610 GPM = 3.59 CFS

$$2.00 \times \text{TOTAL DRAINAGE AREA} = 2.00 \times 20.032$$

$$\text{MAX WSE} - \text{CL OF PRIMARY RESTRICTOR} = 67.35 - 58.18$$
$$\text{CA} / 2GH^2 = 0.80 \times 1.05 \text{ } 1/2 \text{ } (2 \times 32 \times 9 \text{ } 1/2)$$

$$Q - Q^2 = 40,064 - 20,316$$
$$\text{MAX WSE} - \text{CL OF SECONDARY RESTRICTOR} = 67.35 - 65.73$$
$$Q^H \text{ } 1/2 \text{ } (2.25H^H \text{ } 1/4) = 1.75 \text{ FEET}$$

20.032 ACRES
40,064 CFS (BASED ON 2.0 CFS/AC)
9.17 FT
20,316 CFS (BASED ON D_{L1} AND H_{L2})
19,748 CFS (BASED ON Q AND Q_2)
1.62 FEET
 $D^H = 18 \text{ INCHES}$
2 PUMPS RUNNING @ 1610 GPM = 7.18 CFS

SWQ CALCULATIONS

- DRAINAGE AREA
TOTAL DRAINAGE AREA = 20.032 ACRES
- WATER QUALITY TREATMENT VOLUME:
 $V_{wq} = 0.5 \text{ in} \times 1 \text{ ft} / 12 \text{ in} \times 20.032 \text{ ACRES} = 0.835 \text{ ACRE- FEET}$
- DETENTION POND:
TOTAL AREA = 137,029 SQ FT (CALCULATED BY AUTOCAD 2020)
- TOTAL HEAD:
TOE OF POND = 55.50
WATER QUALITY WSE = 57.85
 $H = 57.85 - 55.50 = 2.35 \text{ FEET}$
- ORIFICE AREA REQUIRED:
 $A_p = \frac{V_{wq}}{120.3 \times \Delta t \times \sqrt{H}} = \frac{0.835 \text{ ACRE- FEET} \times 43,560 \text{ ft}^2/\text{acre}}{120.3 \times 24 \text{ hr} \times 2.35 \text{ FEET}}$
 $A_p = 8.24 \text{ in}^2$
USE 10 ONE-INCH DIAMETER HOLES

PUMP DOWN DRAIN TIME CALCULATIONS:


TOTAL DETENTION VOLUME PROVIDED	334,638 CU FT
2 PUMPS RUNNING @ 1610 GPM EACH	3220 GPM TOTAL
CFS = GPM / 449 =	3220 GPM TOTAL / 449 = 7.18 CFS
TIME TO DRAIN ENTIRE POND = VOLUME PROVIDED / OUTFLOW CFS	334,638 CU FT / 7.18 CFS = 46,606.96 SECONDS
46,606.96 SECONDS / 3,600 =	12.95 HOURS

CALL BEFORE YOU DIG
TEXAS ONE CALL PARTICIPANTS REQUEST
72 HOURS NOTICE BEFORE YOU DIG, DRILL
OR BLAST - STOP CALL
TEXAS ONE CALL SYSTEM
1-800-545-6005
IN HOUSTON
(713)-223-4567

APPROVED STORM DRAINAGE

Stormwater runoff shall not cross property line. The construction of the proposed improvements shall not cause the capacity of any part of the existing C.O.H storm system to be exceeded. Responsibility for any impact on the C.O.H system lies with the designer of proposed project.

Jahs Nkululeko 10/14/2021
STORM FORM LOG #: 2020-01176

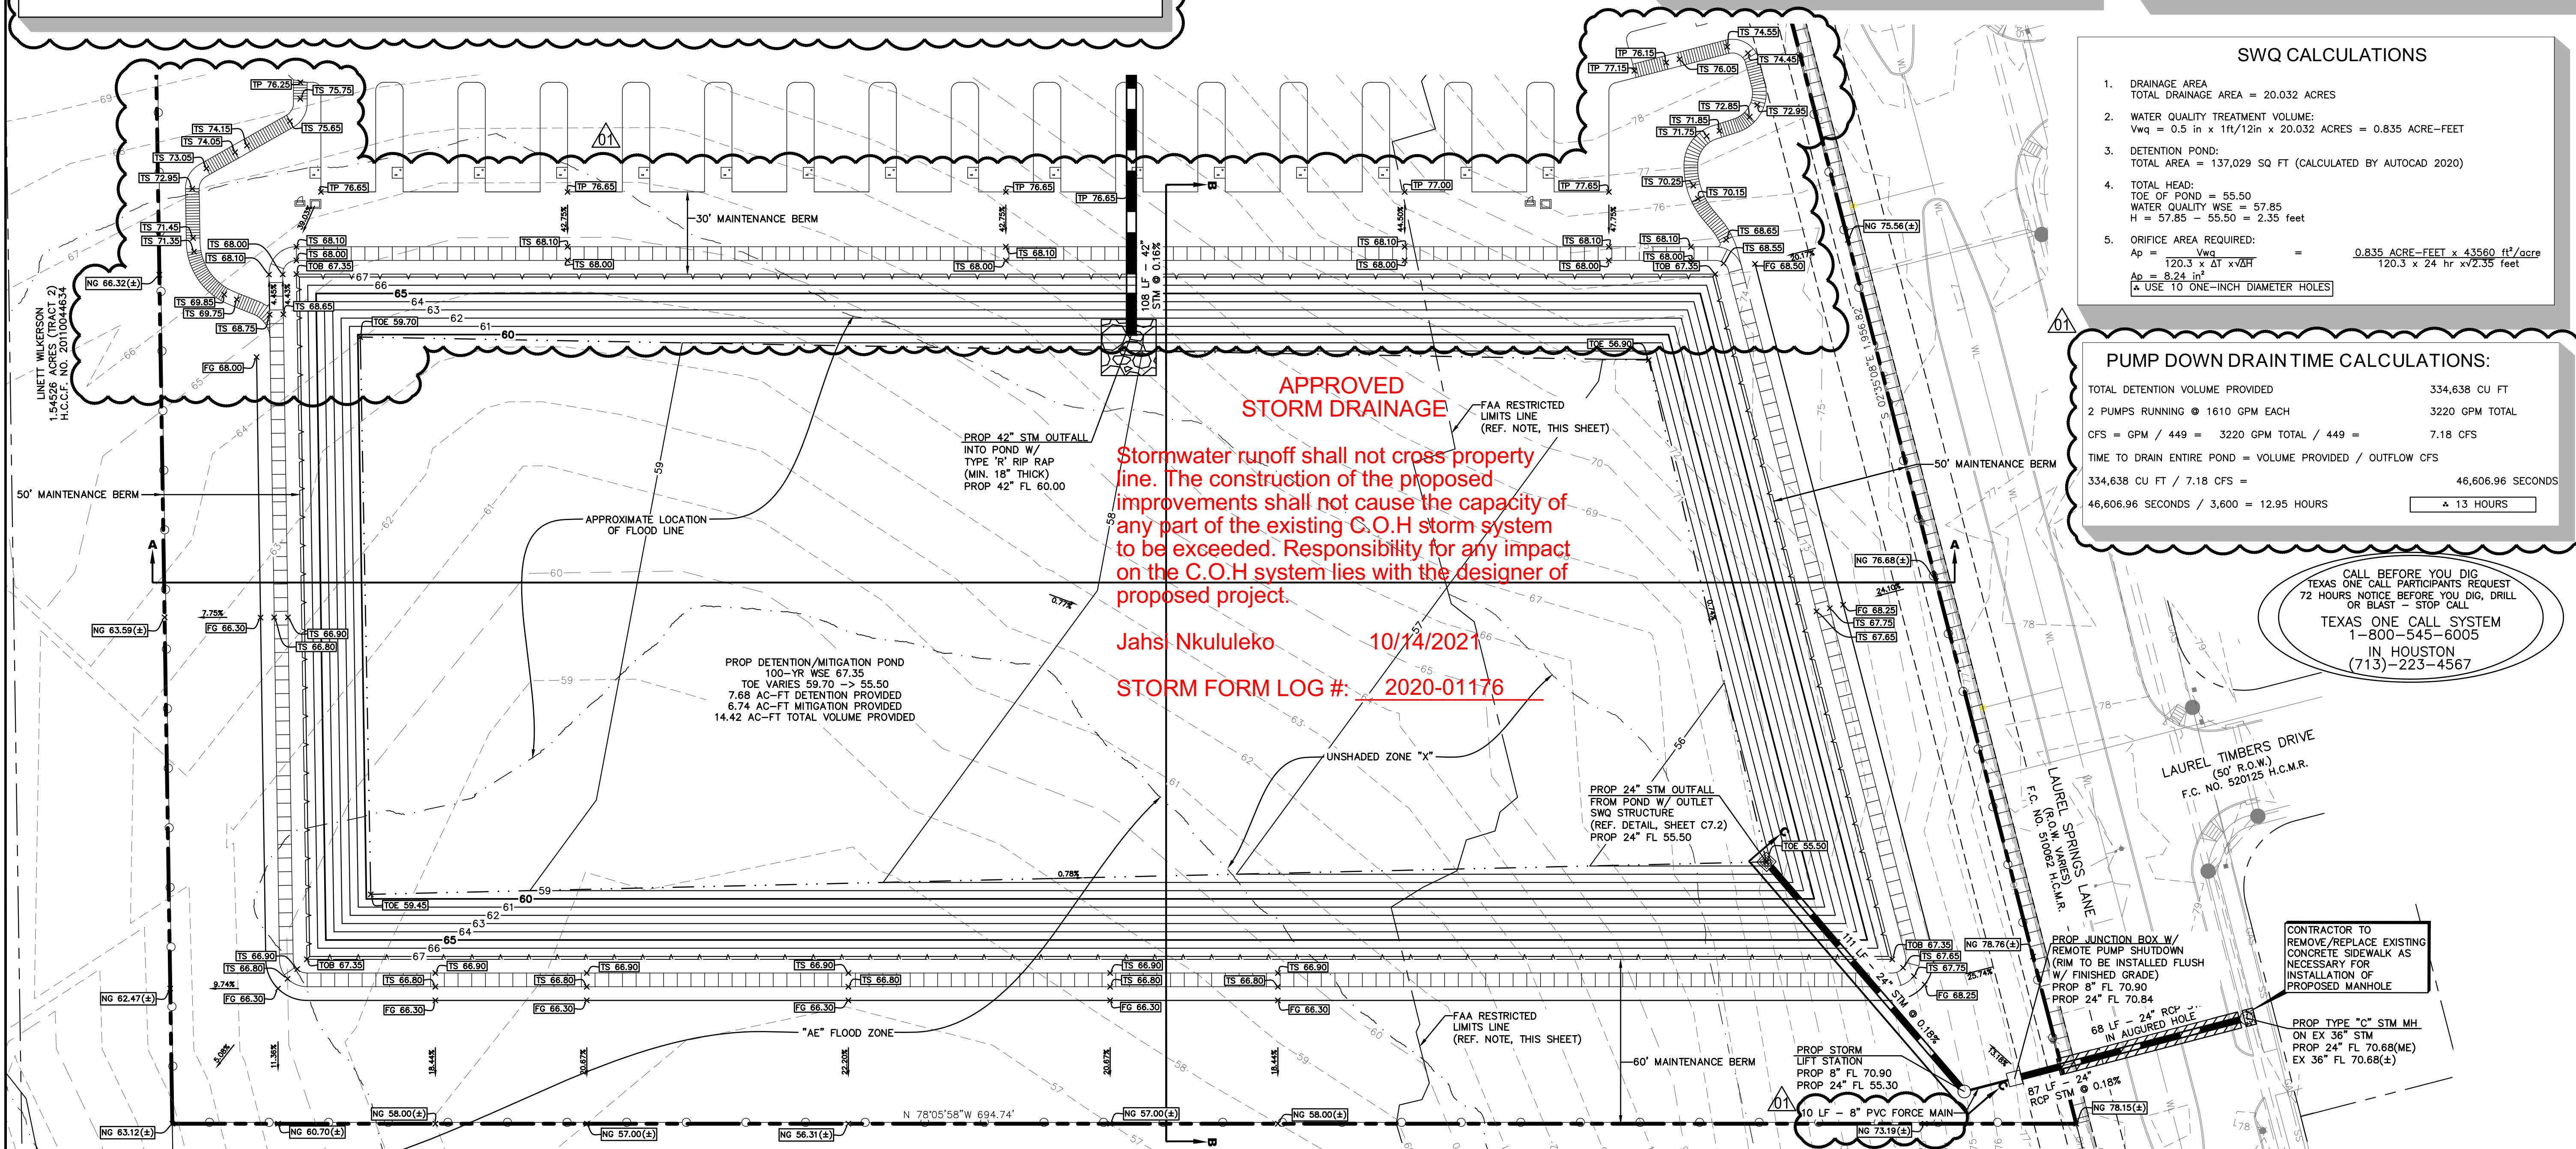

DETENTION & MITIGATION POND PLAN

LAUREL SPRINGS
RV RESORT
1355 LAUREL SPRINGS LANE
HOUSTON, TEXAS

SHEET
C3.4