



REVIEWED FOR COMPLIANCE  
 Performance of this review does not relieve the applicant from full responsibility to comply with all applicable codes and ordinances in regulations  
 01/21/21

**MULTIPLE EXISTING PUBLIC AND PRIVATE UTILITY LINES EXIST ON THIS SITE. THE UTILITY LINES SHOWN ON THESE DRAWINGS REFLECT INFORMATION OBTAINED FROM RECORD DRAWINGS AND MAY NOT INCLUDE ALL EXISTING UTILITIES. CONTRACTOR IS TO USE EXTREME CAUTION DURING ALL CONSTRUCTION ACTIVITIES AND IS SOLELY RESPONSIBLE FOR DAMAGE TO EXISTING FACILITIES.**

**FLOODPLAIN NOTE:**  
 BFE = 66.00' (100-YR) & 68.75' (500-YR)  
 ACCORDING TO THE MAP NO. 48201C0295M AND 48201C0315L OF THE FEDERAL EMERGENCY MANAGEMENT AGENCY'S FLOOD RATE MAPS, DATED JUNE 9, 2014 AND JUNE 18, 2007, THE SITE LIES IN UNSHADED ZONE "X", SHADED ZONE "X", ZONE "AE".

**DETENTION FACILITY MAINTENANCE NOTE:**  
 THE PROPOSED PRIVATE DETENTION FACILITY IS TO BE MAINTAINED BY THE PROPERTY OWNER.


**MITIGATION CALCS:**

TOTAL FLOODPLAIN FILL	10,619 CY
TOTAL FLOODPLAIN CUT	10,869 CY
NET CUT	250 CY CUT

\*ALL NUMBERS HAVE BEEN CALCULATED THROUGH AUTOCAD 2020 CIVIL 3D MODELING.

**GENERAL NOTES**

- CONTRACTOR TO ADJUST ALL EXISTING AND PROPOSED UTILITY APPURTENANCES TO FINISHED GRADE.
- ALL EXCAVATED MATERIAL TO BE HAULED OFFSITE.

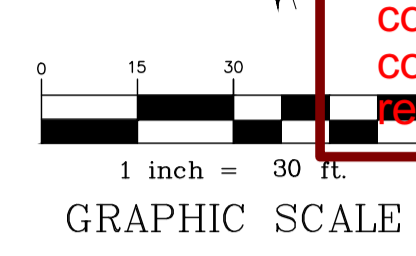

**FAA RESTRICTED NOTE:**  
 PURSUANT TO FAA ADVISORY CIRCULAR 150/5200-33B 2-3 SUB-SECTION B: STORM WATER DETENTION PONDS SHOULD BE DESIGNED, ENGINEERED, CONSTRUCTED, AND MAINTAINED FOR A MAXIMUM 48-HOUR DETENTION PERIOD AFTER THE DESIGN STORM AND REMAINS COMPLETELY DRY BETWEEN STORMS.

**DETENTION DRAINAGE NOTE:**  
 ALL SUBSURFACE DRAINAGE SYSTEMS ARE REQUIRED TO BE DRAINED IN 48 HOURS.

**TOTAL DETENTION/MITIGATION POND VOLUME SUMMARY**

TOTAL DETENTION VOLUME PROVIDED	334,638 CU FT
TOTAL MITIGATION VOLUME PROVIDED	293,463 CU FT
TOTAL STORAGE VOLUME PROVIDED	628,101 CU FT

**IMPERVIOUS COVER CALCS:**

TOTAL SITE ACREAGE = 20.032 ACRES  
 TOTAL IMPERVIOUS COVER = 13.349 ACRES  
 PERCENTAGE OF TOTAL IMPERVIOUS COVER = 66.64%

**RESTRICTOR CALCULATIONS**

MAX WSE = 67.35  
 75% WSE = 64.98  
 25% WSE = 60.23

LOW LEVEL RESTRICTOR (25% FLOW)  
 TOTAL DRAINAGE AREA = 20.032 ACRES  
 OUTFLOW RATE ALLOWED FOR LOW FLOW  $Q^1 = 10.016$  CFS (BASED ON 0.5 CFS/AC)  
 HEAD  $H^1$  (WATER SURFACE DIFFERENTIAL FOR LOW FLOW = 0.38 FEET)  
 CALCULATED LOW LEVEL RESTRICTOR SIZE  $D^1 = 2 - 6" \times 1 - 8" \text{ DIAMETER HOLES}$

HIGH LEVEL RESTRICTOR (75% FLOW)  
 TOTAL DRAINAGE AREA = 20.032 ACRES  
 OUTFLOW RATE ALLOWED FOR HIGH FLOW  $Q^2 = 22.977$  CFS (BASED ON 2.0 CFS/AC)  
 HEAD  $H^2$  (WATER SURFACE DIFFERENTIAL FOR HIGH FLOW = 1.62 FEET)  
 CALCULATED HIGH LEVEL RESTRICTOR SIZE  $D^2 = 18$  INCHES

**DETENTION CALCULATIONS**

TOTAL SERVICE AREA = 20.032 AC  
 EXISTING IMPERVIOUS COVER = 0 AC  
 PROPOSED IMPERVIOUS COVER = 13.349 AC  
 INCREASED IMPERVIOUS COVER = 13.349 AC

REQUIRED DETENTION VOLUME = 6,675 AC-FT  
 PROVIDED DETENTION VOLUME = 7,882 AC-FT  
 OUTFLOW RATE ALLOWED FOR LOW FLOW = 10.016 CFS  
 OUTFLOW RATE ALLOWED FOR HIGH FLOW = 24.432 CFS  
 OUTFLOW RATE PROVIDED FOR LOW FLOW = 7.810 CFS  
 OUTFLOW RATE PROVIDED FOR HIGH FLOW = 14.463 CFS

PRIMARY RESTRICTOR SIZE = 2 - 6" & 1 - 8" DIAMETER HOLES  
 SECONDARY RESTRICTOR SIZE = 18 IN

**TOTAL DETENTION VOLUME REQUIRED**

$V_1 = [43,560 \times (0.50 \times A_p)]$   
 $V_1 = \text{TOTAL DETENTION VOLUME FOR THE PROPOSED PROJECT (CUBIC FEET)}$   
 $A_p = \text{AREA OF INCREASED IMPERVIOUS COVER (ACRES)}$   
 $V_1 = [43,560 \times (0.50 \times 13.349)] = 290,763 \text{ CU FT}$

**TOTAL DETENTION VOLUME PROVIDED**


TOTAL DETENTION PROVIDED = 334,638 CU FT  
 DETENTION PROVIDED IN POND = 334,638 CU FT

**LEGEND**

●	EX. MANHOLE
—	EX. STORM SEWER
—	EX. WATER LINE
—	EX. SANITARY SEWER LINE
—	EX. OVERHEAD POWER LINE
—	EX. UNDERGROUND GAS LINE
—	EX. CONTOUR
—	PROPOSED STORM SEWER
—	PROPOSED GRATE INLET

**SWQ CALCULATIONS**

- DRAINAGE AREA TOTAL DRAINAGE AREA = 20.032 ACRES
- WATER QUALITY TREATMENT VOLUME:  $V_{wq} = 0.5 \text{ in} \times 11/12 \text{ in} \times 20.032 \text{ ACRES} = 0.835 \text{ ACRE-FEET}$
- DETENTION POND: TOTAL AREA = 137,029 SQ FT (CALCULATED BY AUTOCAD 2020)
- TOE OF POND = 55.50  
 WATER QUALITY WSE = 57.85  
 $H = 57.85 - 55.50 = 2.35 \text{ FEET}$
- ORIFICE AREA REQUIRED:  $A_p = 120.3 \times \Delta t \times \sqrt{2H} = 120.3 \times 24 \text{ hr} \times \sqrt{2.35} = 8.24 \text{ in}^2$   
 (USE 10 ONE-INCH DIAMETER HOLES)

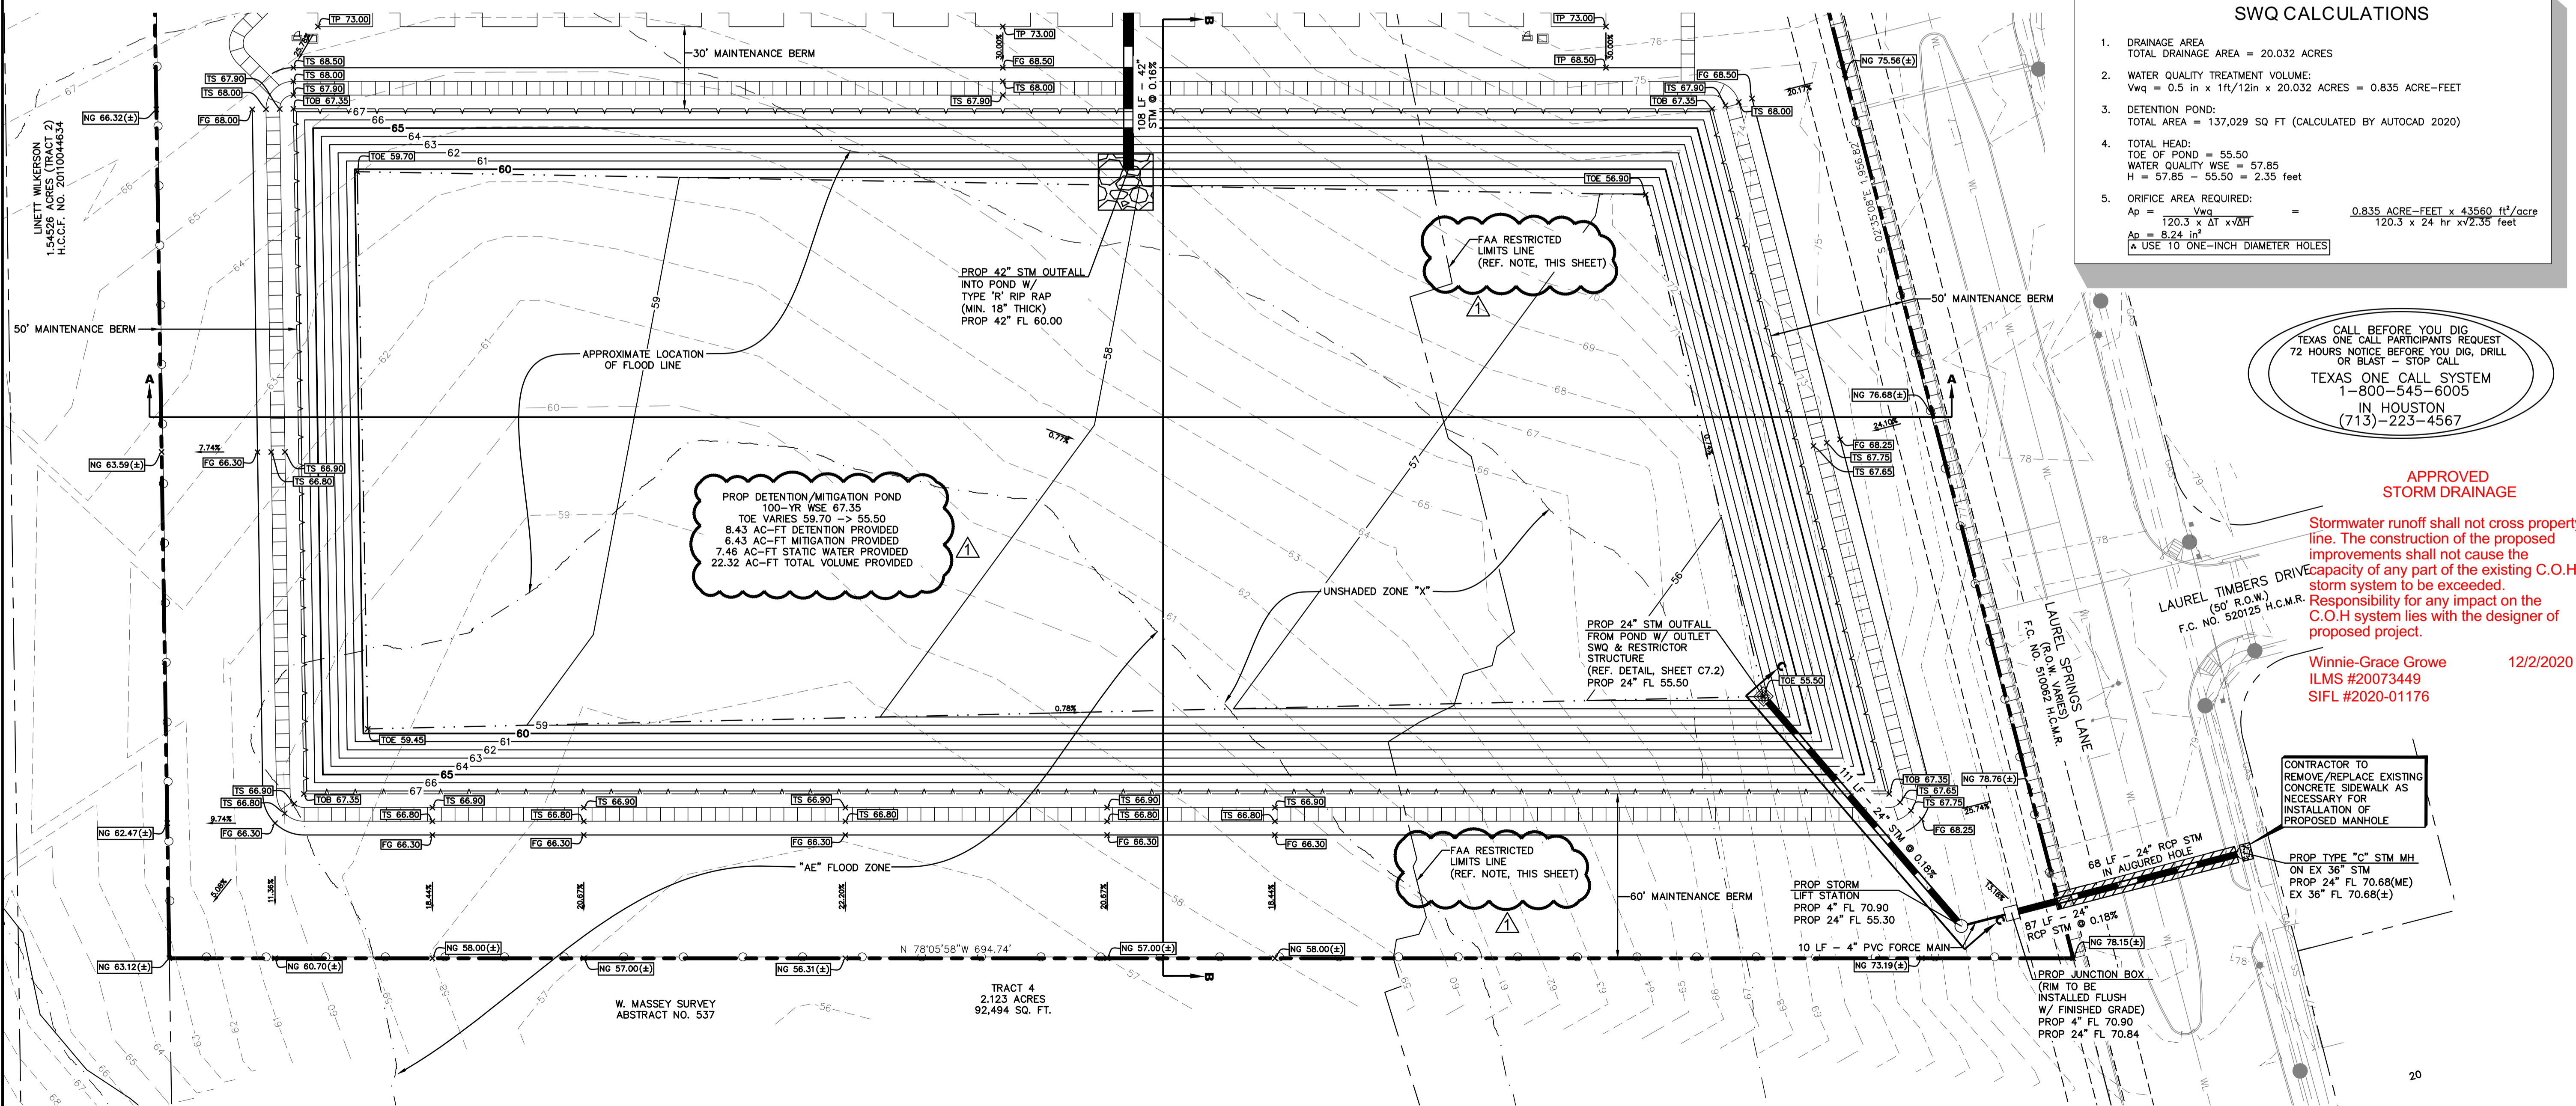


CALL BEFORE YOU DIG  
 TEXAS ONE CALL PARTICIPANTS REQUEST 72 HOURS NOTICE BEFORE YOU DIG, DRILL OR BLAST - STOP CALL  
 TEXAS ONE CALL SYSTEM  
 1-800-545-6005  
 IN HOUSTON  
 (713)-223-4567

APPROVED STORM DRAINAGE  
 Stormwater runoff shall not cross property line. The construction of the proposed improvements shall not cause the capacity of any part of the existing C.O.H storm system to be exceeded. Responsibility for any impact on the C.O.H system lies with the designer of proposed project.  
 Winnie-Grace Growe  
 ILMS #20073449  
 SIFL #2020-01176  
 12/2/2020

CONTRACTOR TO REMOVE/REPLACE EXISTING CONCRETE SIDEWALK AS NECESSARY FOR INSTALLATION OF PROPOSED MANHOLE

NO.	REVISIONS	DATE
1	CITY OF HOUSTON COMMENTS	09/09/2020
2	CITY OF HOUSTON COMMENTS	11/19/2020

**ALJ Lindsey**  
 Civil Engineer, State #14  
 Houston, TX 77006  
 FRN#11526

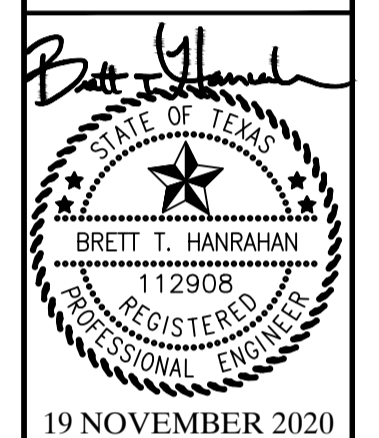

19 NOVEMBER 2020  
 ALL PROJECT NO. 031.19.CY.039  
 DATE: NOV. 2020  
 SCALE: 1:30  
 DRAWN BY: DAD  
 CHECKED BY: KAD

**DETENTION & MITIGATION POND PLAN**

**LAUREL SPRINGS RV RESORT**  
 1355 LAUREL SPRINGSLANE  
 HOUSTON, TEXAS

SHEET  
**C3.4**